

The *** bedroom dwelling will produce ***L of wastewater/day.

Disposed over ***m² at ***L/m²/day.

There will be *** rows of drip irrigation lines ***m long and 1m apart, buried 150mm deep.

Netafim Bioline™ AS.
2.3 l/h
OD 16.6mm
ID 14.2mm

The installation of the wastewater treatment plant and land application area will be done in general accordance with:

NZ building Code Clause G13/VM4.
AS/NZS 1547:2012

The construction of the wastewater treatment plant is in general accordance with:

AS/NZS 1546.1:2008
AS/NZS 3106:2009
TP58

As Built plans are drawn off the supplied drawing from the sub contractor. Wright Tanks Ltd do not survey the site and therefore take no responsibility for the accuracy of such plots.


Plans are drawn off a supplied drawing. Wright Tanks Ltd do not survey the site for boundary dimensions or building and driveway location. These are approximate and may vary to exact locations. See architectural site plan for exact measurements and locations. Wright Tanks Ltd therefore take no responsibility for the accuracy of such dimensions.

Site Plan to be read in conjunction with the enclosed site inspection report.

Name:	*****
Address:	*****
Drawn By:	**** **
Scale:	Do not scale
Date:	00/00/2014
Ref #:	*****
Signed:	

fp: 0800 253 273
t: 06 353 6157 f: 06 353 3020
PO Box 4777 Palmerston North 4442
email: admin@wrighttanks.co.nz
www.wrighttanks.co.nz

This design remains the property of Wright Tanks Limited and may not be altered, reproduced or installed (wholly or in part) by any person not accredited as a Wright Tanks Limited approved installer.

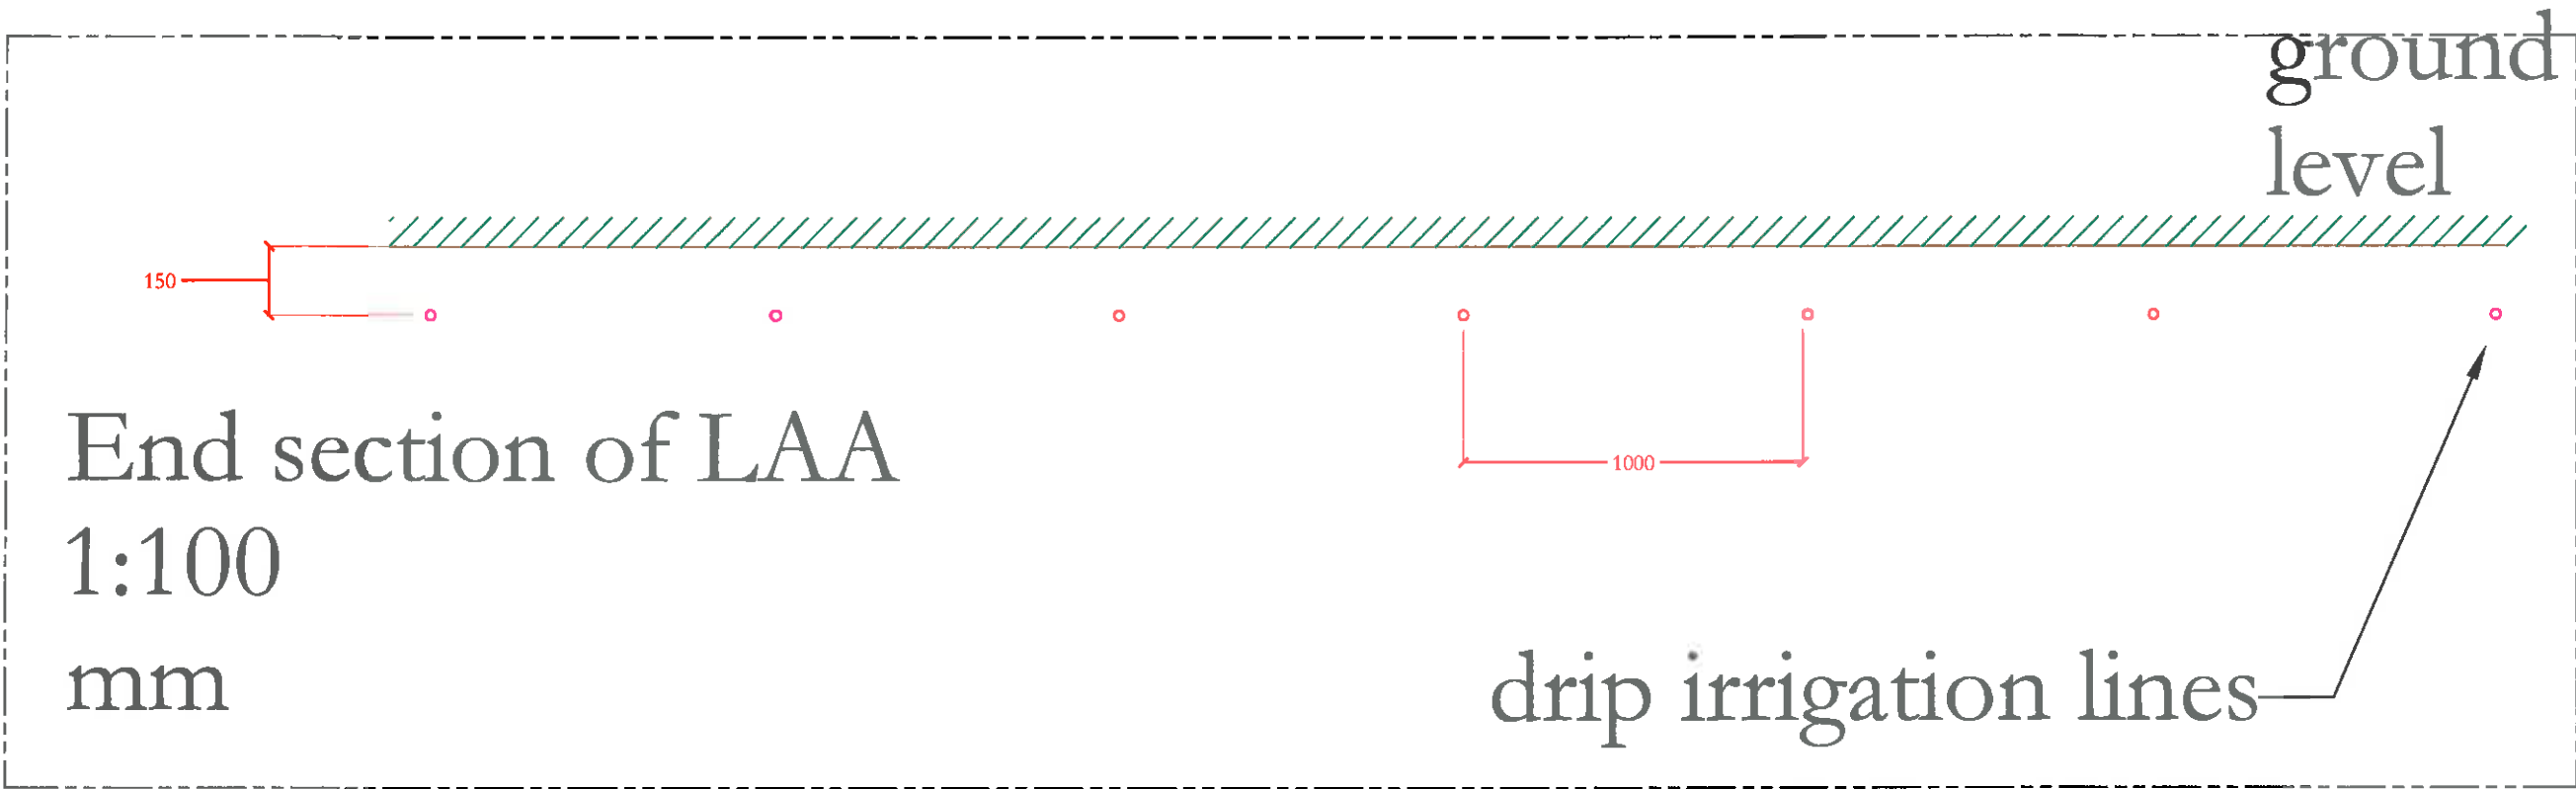

Building location and design approximate only. Please see architectural plans for exact details